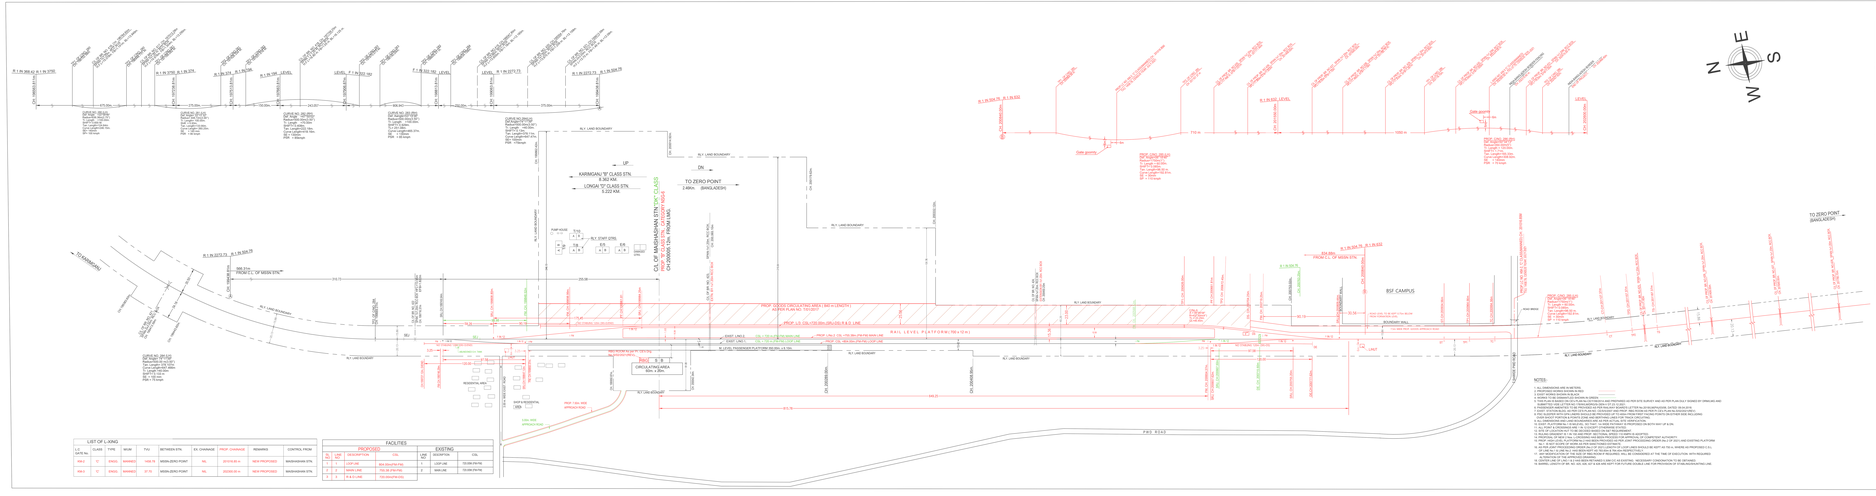

Signature block	
CPEE	YOGESH VERMA — Digitally signed by YOGESH VERMA Date: 2022.02.01 13:02:23 +05'30'
CTPM	RAGHAB GAUTAM Digitally signed by RAGHAB GAUTAM Date:2022.02.01 10:46:53 +05'30'
HQ–ENGG–RDN–MLG	TAPAS SUTRADHAR Digitally signed by TAPAS SUTRADHAR Date:2022.01.28 06:20:16 +05'30'
CSTE–C–MLG	VIJAI SINGH MEENA Digitally signed by VIJAI SINGH MEENA Date:2022.01.31 01:27:23 +05'30'
CE–CON–1–MLG	BHARAT NANDAN BHAGAWAT Digitally signed by BHARAT NANDAN BHAGAWAT Date:2022.01.21 21:03:36 +05'30'
CEE–C–MLG	SANJAY NAYYAR Digitally signed by SANJAY NAYYAR Date:2022.01.21 05:17:26 +05'30'
DY. CSTE–C–PL	UTPAL KALITA Digitally signed by UTPAL KALITA Date:2022.01.21 11:04:46 +05'30'
DYCON–C–MLG	PREMENDU SOYMOPAR Digitally signed by PREMENDU SOYMOPAR Date:2021.11.23 22:19:24 +05'30'
DYCE–C–IECRAQ–MLG	DILEPAK KUMAR GUPTA Digitally signed by DILEPAK KUMAR GUPTA Date:2021.12.24 09:29:52 +05'30'
DYCEE–C–SGL	Sujoi Chandra Roy Digitally signed by Sujoi Chandra Roy Date:2021.07.13 12:02:38 +05'30'
DYCSTE–C–SGL	ANUJ KUMAR CHAWAR Digitally signed by ANUJ KUMAR CHAWAR Date:2021.07.13 08:20:43 +05'30'
DYCE–C–PL–1	SAURABH KUMAR Digitally signed by SAURABH KUMAR Date:2021.10.12 10:15:44 +05'30'
AEN–C–PL	JOYSHREE MALAKAR Digitally signed by JOYSHREE MALAKAR Date:2021.10.11 07:59:59 +05'30'
DYCE–C–LMG–1	Suryabhan Digitally signed by Suryabhan Date:2021.07.13 05:48:34 +05'30'
SSE–C–DRG–PL	SORAJ PRAKASH MAWSHAR Digitally signed by SORAJ PRAKASH MAWSHAR Date:2021.10.11 05:10:07 +05'30'
AEN–C–LMG–SG–1	KISHOR KALITA Digitally signed by KISHOR KALITA Date:2021.07.12 05:34:55 +05'30'
SSE–C–PWAY–LM C/ AT SGL	AMIT FERNANDEZ Digitally signed by AMIT FERNANDEZ Date:2021.07.12 05:19:40 +05'30'
C–MCI–1/SSE I–C–SRC	MATI RAM RABHA Digitally signed by MATI RAM RABHA Date:2021.07.07 04:30:42 +05'30'

NOTES:

1. ALL DIMENSIONS ARE IN METERS.
2. PROPOSED WORKS SHOWN IN RED
3. EXISTING WORKS SHOWN IN BLACK
4. DORMA 110 MM SUBMERSIBLE SHOWN IN GREEN
5. ALL LEVELS, DIMENSIONS AND CONDITIONS TO BE VERIFIED AND PREPARED AS PER SITE SURVEY AND AS PER PLAN DULY SIGNED BY OPWG AND SUBMITTED. ANY DISCREPANCY IN DIMENSIONS OR LEVELS TO BE REPORTED TO THE DESIGN ENGINEER BEFORE ACTUAL WORK.
6. EXISTING STATION BUILDING AS PER DETAILS AS ON 15/02/2021 AND PROP. PWD DESIGN AS PER PLAN DULY SIGNED BY PWD.
7. EXISTING STATION BUILDING AS PER DETAILS AS ON 15/02/2021 AND PROP. PWD DESIGN AS PER PLAN DULY SIGNED BY PWD.
8. ROAD SURFACE PLANTATION & OPEN SPACE ZONE AND NEEDTHINNED LINES ARE TAKEN FROM GOOGLE IMAGE.
9. ALL DIMENSIONS ARE TAKEN FROM GOOGLE IMAGE AND ARE ONLY APPROXIMATE.
10. SLOPE, PLATFORMS & CANOPIES, ETC TAKEN TO ABOW ROYAL'S AS PROVIDED ON BOTH SIDY OF S.ON.
