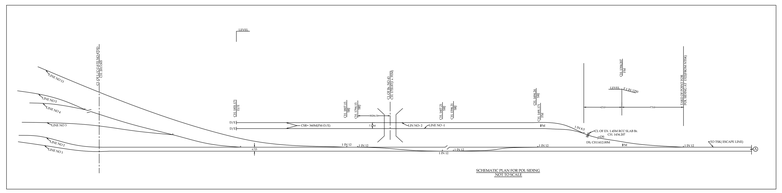

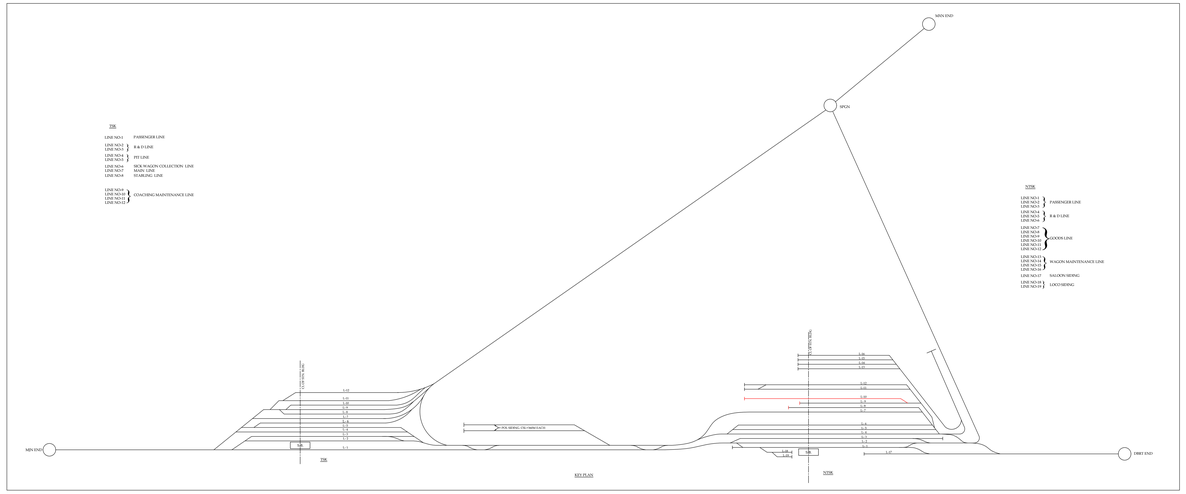

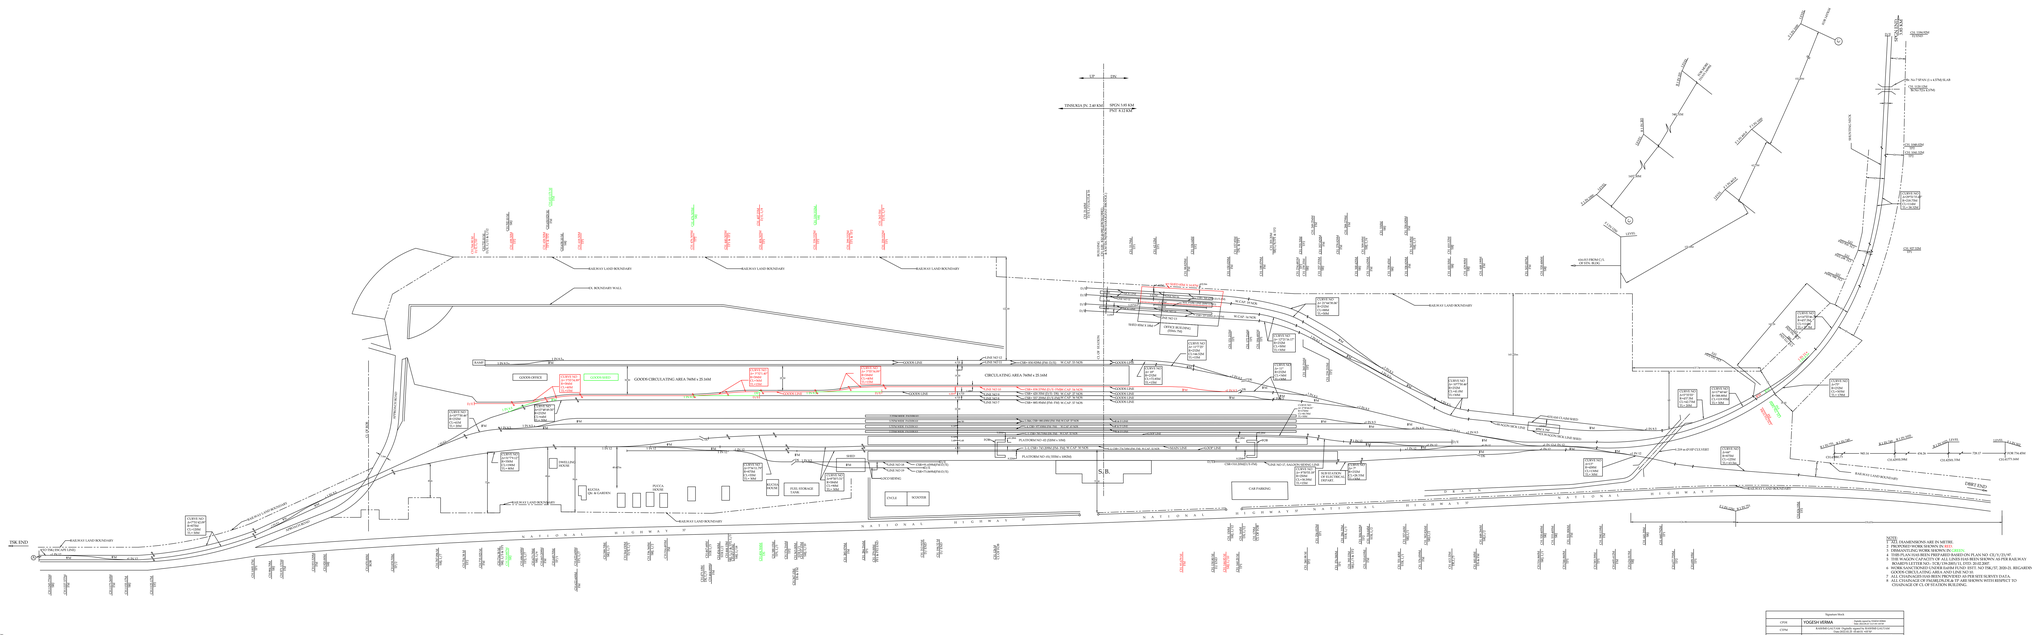

NOTES
1. ALL DIMENSIONS ARE IN METRE.
2. ALL LEVELS ARE IN METRE.
3. EMBANKING WORK BEHIND RL 1.5 MTRS.
4. THE WORK SHOWN IN RED COLOUR IS ON PLAN NO. CE/TL/TE/97
6. WORK MANTIONED UNDER PARIPATANI DET. 342 TRK/PT. 2020-21 REGARDING GOODS CIRCULATING AREA AND LINE NO-9R.
7. ALL DIMENSIONS ARE BASED ON ON THE SITE SURVEY DATA.
8. ALL CHAINAGE OF PARELIPLICK P.T ARE SHOWN WITH RESPECT TO CHAINAGE OF CL OF STATION BUILDING.

Designed Stock		
CTPM	YOGESH VERMA	Capacity Assessed, Yards Layout, Operational Feasibility

PLAN NO. CE/TL/TE/2022

N.F. RAILWAY
TINSUKIA DIVISION
AT NEW TINSUKIA YARD
ESP IN CONNECTION WITH YARD REMODELING

SCALE : 1: 1000	PLAN NO. TRK/YM/2021