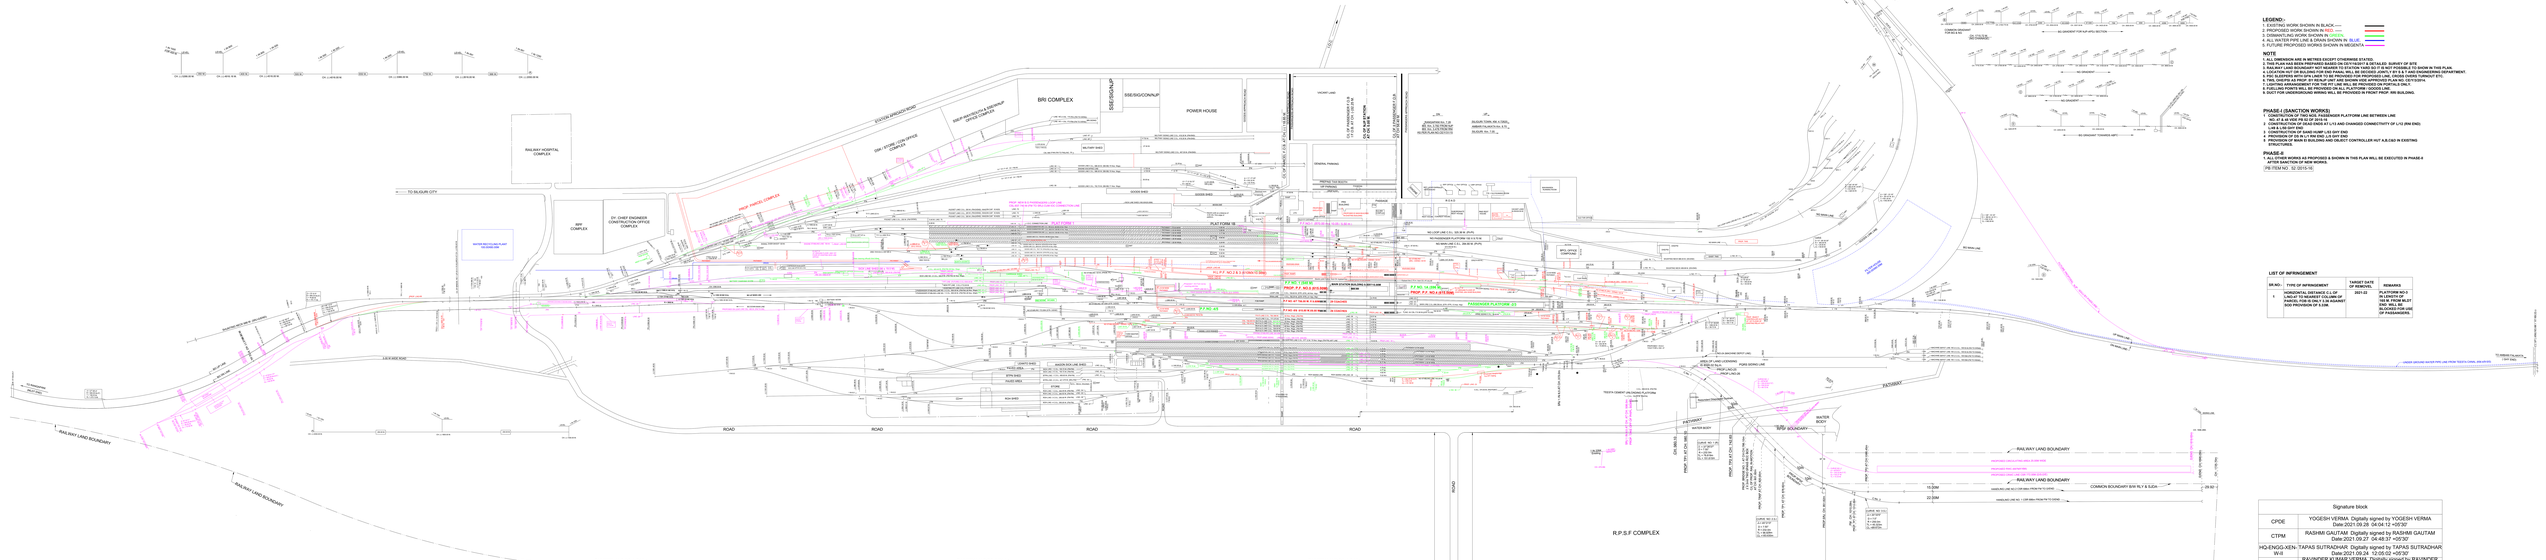

LEGEND:

1. EXISTING WORK SHOWN IN BLACK ----
2. PROPOSED WORK SHOWN IN RED ----
3. DISMANTLING WORK SHOWN IN CYAN ----
4. ALL WATER PIPE LINE & DRAIN SHOWN IN BLUE ----
5. ALL OTHER PROPOSED WORKS SHOWN IN MAGENTA ----

NOTE

1. **ALL DIMENSION ARE IN METRES EXCEPT OTHERWISE STATED.**
2. **THIS PLAN HAS BEEN PREPARED BASED ON ESTIVEMENT & DETAILED SURVEY OF SITE**
3. **ALL EXISTING UTILITIES ARE NOT SHOWN IN THE PLAN. IT IS NOT POSSIBLE TO SHOW IN THE PLAN.**
4. **LOCATION NOT OB BRIDGE FOR END PANAL WILL BE DECIDED JOINTY BY S & T AND ENGINEERING DEPARTMENT.**
5. **ALL DIMENSION ARE TO BE CHECKED BY CONCERNED DEPARTMENT BEFORE CONSTRUCTION.**
6. **TBL GIRDER AS PER DT-25-06-07 (407 AND 50/1000 GIRDER) WERE APPROVED PLAN NO. 02/15/2010.**
7. **LIGHTING ARRANGEMENT FOR THE PT LINE WILL BE PROVIDED ON PORTALS ONLY.**
8. **ALL DIMENSION ARE TO BE CHECKED BY CONCERNED DEPARTMENT.**
9. **EXIT FOR UNDERGROUND WIRING WILL BE PROVIDED IN FRONT PROP. NR BUILDING.**

PHASE-I (SANCTION WORKS)

1. **PROVISION OF FOOT OVER BRIDGE/NEW PLATFORM LINE BETWEEN LNG NO. 4T & W FOR FB 02 OF 2013-14.**
2. **PROVISION OF NEW PLATFORM 1B LINE AND CHANGED CONNECTIVITY OF L/U (RW END) LNG & L/SD (SIY END)**
3. **PROVISION OF NEW PLATFORM LINE (NBF) L/SD (SIY END)**
4. **PROVISION OF 20 M L/T RM END, L/S (SIY END)**
5. **PROVISION OF MAIN BUILDING AND OBJECT CONTROLLER HUT A.B.C&D IN EXISTING STRUCTURES.**

PHASE-II

1. **ALL OTHER WORKS AS PROPOSED & SHOWN IN THIS PLAN WILL BE EXECUTED IN PHASE-II AFTER SANCTION OF NEW WORKS.**

PS ITEM NO : 52 (2015-16)

LIST OF INFRINGEMENT

SR.NO.	TYPE OF INFRINGEMENT	TARGET DATE OF REMOVAL	REMARKS
1	HORIZONTAL DISTANCE L.C. 06 (RC 15) LTS FROM SAF WHEEL OF PROP. PANEL FOR 20.0M L/ S IN AGRANT DIS PROVISION OF 5.0M.	2021-22	PLATFORM NO 5 & 7 IN LENGTH OF 550M. ACCORDING TO RDSO-2021 DIS. WILL BE BLOCKED FOR LINE OF PASSANGERS.

Signature block

CPDE	YOGESH VERMA Digitally signed by YOGESH VERMA Date:2021.09.28 04:04:12 +05'30'
CTPM	RASHMI GAUTAM Digitally signed by RASHMI GAUTAM Date:2021.09.27 04:46:57 +05'30'
HQ-ENGG-XEN-W-II	TAPAS SUTRADHAR Digitally signed by TAPAS SUTRADHAR Date:2021.09.24 12:05:02 +05'30'
KIR-DRM	RAVINDER KUMAR VERMA Digitally signed by RAVINDER KUMAR VERMA Date:2021.07.28 08:58:20 +05'30'
KIR-SRDEN-C	SAHEMLING KAMEI Digitally signed by SAHEMLING KAMEI Date:2021.07.13 04:34:02 +05'30'
KIR-SRDDM	PRASHANTKUMAR PURUSHOTTAM GAJBHIYE Digitally signed by PRASHANTKUMAR PURUSHOTTAM GAJBHIYE Date:2021.07.13 04:37:29 +05'30'
KIR-SRSDE	PAWAN KUMAR Digitally signed by PAWAN KUMAR Date:2021.04.21 08:27:30 +05'30'
KIR-SRDEE-GN	DEBJIT MISRA Digitally signed by DEBJIT MISRA Date:2021.05.05 08:15:04 +05'30'
KIR-DEN-LINE	AMANDEEP KAMBOJ Digitally signed by AMANDEEP KAMBOJ Date:2021.04.19 04:01:58 +05'30'
SSE-DRG	SANJAY KUMAR JHA Digitally signed by SANJAY KUMAR JHA Date:2021.04.12 12:24:23 +05'30'
JE-DRG	VIKAS KUMAR MALAKAR Digitally signed by VIKAS KUMAR MALAKAR Date:2021.04.05 11:00:55 +05'30'

ALT 1

(a) ONE D/END PROPOSED ON LINE NO. 13 AT ABFC END , ACCORDINGLY CSL OF L/11 & L/12 ARE CORRECTED AND CROSSOVER PROVIDED.

(b) ONE D/S PROPOSED ON LINE NO. 9 AT RNI END AND ACCORDINGLY CSL CORRECTED.

ALTERATIONS ARE DONE AS PER GM/ S&T MLG.S LETTER NO. N/225/3480 AND DT. 08/11/2021.

Signature block	
CPDE	YOGESH VERMA Digitally signed by YOGESH VERMA Date:2021.11.10 05:18:17 +05'30'
CTPM	RASHMI GAUTAM Digitally signed by RASHMI GAUTAM Date:2021.11.10 03:59:39 +05'30'
HQ-ENGG-XEN-W-II	TAPAS SUTRADHAR Digitally signed by TAPAS SUTRADHAR Date:2021.11.09 09:00:30 +05'30'

ALT 2

(a) INCLSION OF DS IN ENGINE STABLING LINE (ON PROPOSED L/No.70 AT RNI END).

(b) PROVISION OF DEAD END AT L/S2 AT RNI END. BY SHIFTING OF POINT NO 201 FROM 856.61M TO 886.67M.

(c) DELETION OF DS AND ENGINE STABLING LINE NEAR POINT NO.175A (1 IN 8.5) AT RNI END.

ALTERATIONS ARE DONE AS PER CRS/S.E. CIRCLE/KOLKATA L.No. 71A/SV/VI/PIN/JP/KIR/1921, DT.28.03.2022.

Signature block for ALT-2	
CPDE	YOGESH VERMA Digitally signed by YOGESH VERMA Date:2022.03.28 04:04:12 +05'30'
CHTE	MASOOD ALAM Digitally signed by MASOOD ALAM Date:2022.03.28 04:46:57 +05'30'
CTPM	RASHMI GAUTAM Digitally signed by RASHMI GAUTAM Date:2022.03.28 05:18:17 +05'30'
HQ-ENGG-XEN-W-II	TAPAS SUTRADHAR Digitally signed by TAPAS SUTRADHAR Date:2022.03.28 09:00:30 +05'30'
KIR-DRM	SUVENDU KUMAR CHOUDHURY Digitally signed by SUVENDU KUMAR CHOUDHURY Date:2022.03.28 10:01:26 +05'30'
KIR-SRDEN-C	SAHEMLING KAMEI Digitally signed by SAHEMLING KAMEI Date:2022.03.28 04:34:02 +05'30'
KIR-SRSDM	NIRT SINGH Digitally signed by NIRT SINGH Date:2022.03.28 04:37:29 +05'30'
KIR-SRSDTD	MEETHA LAL MEENA Digitally signed by MEETHA LAL MEENA Date:2022.03.28 03:08:04 +05'30'
KIR-SRDEE-GN	SHAJAD PUDHIAR Digitally signed by SHAJAD PUDHIAR Date:2022.03.28 05:15:04 +05'30'
KIR-SRDEE-TRD	DEBJIT MISRA Digitally signed by DEBJIT MISRA Date:2022.03.28 05:15:04 +05'30'
KIR-DEN-LINE	AMANDEEP KAMBOJ Digitally signed by AMANDEEP KAMBOJ Date:2022.03.28 04:01:58 +05'30'
JE-DRG	SANJAY KUMAR JHA Digitally signed by SANJAY KUMAR JHA Date:2022.03.28 12:24:23 +05'30'

PLAN NO - CE/Y/21/2021

PS ITEM NO.52 OF 2015-16
THIS PLAN SUPERSEDES PLAN NO.02/Y/16/2017

N.F.RAILWAY/ KATIHAR DIVISION
PLAN NO.KIR/Y/02/2017

AT/ALIP
PROPOSED REMODELING OF EXISTING PLATFORM LINES WITH MODIFICATION & REQUIREMENT AT STN & YARD.

SCALE : 1:1000