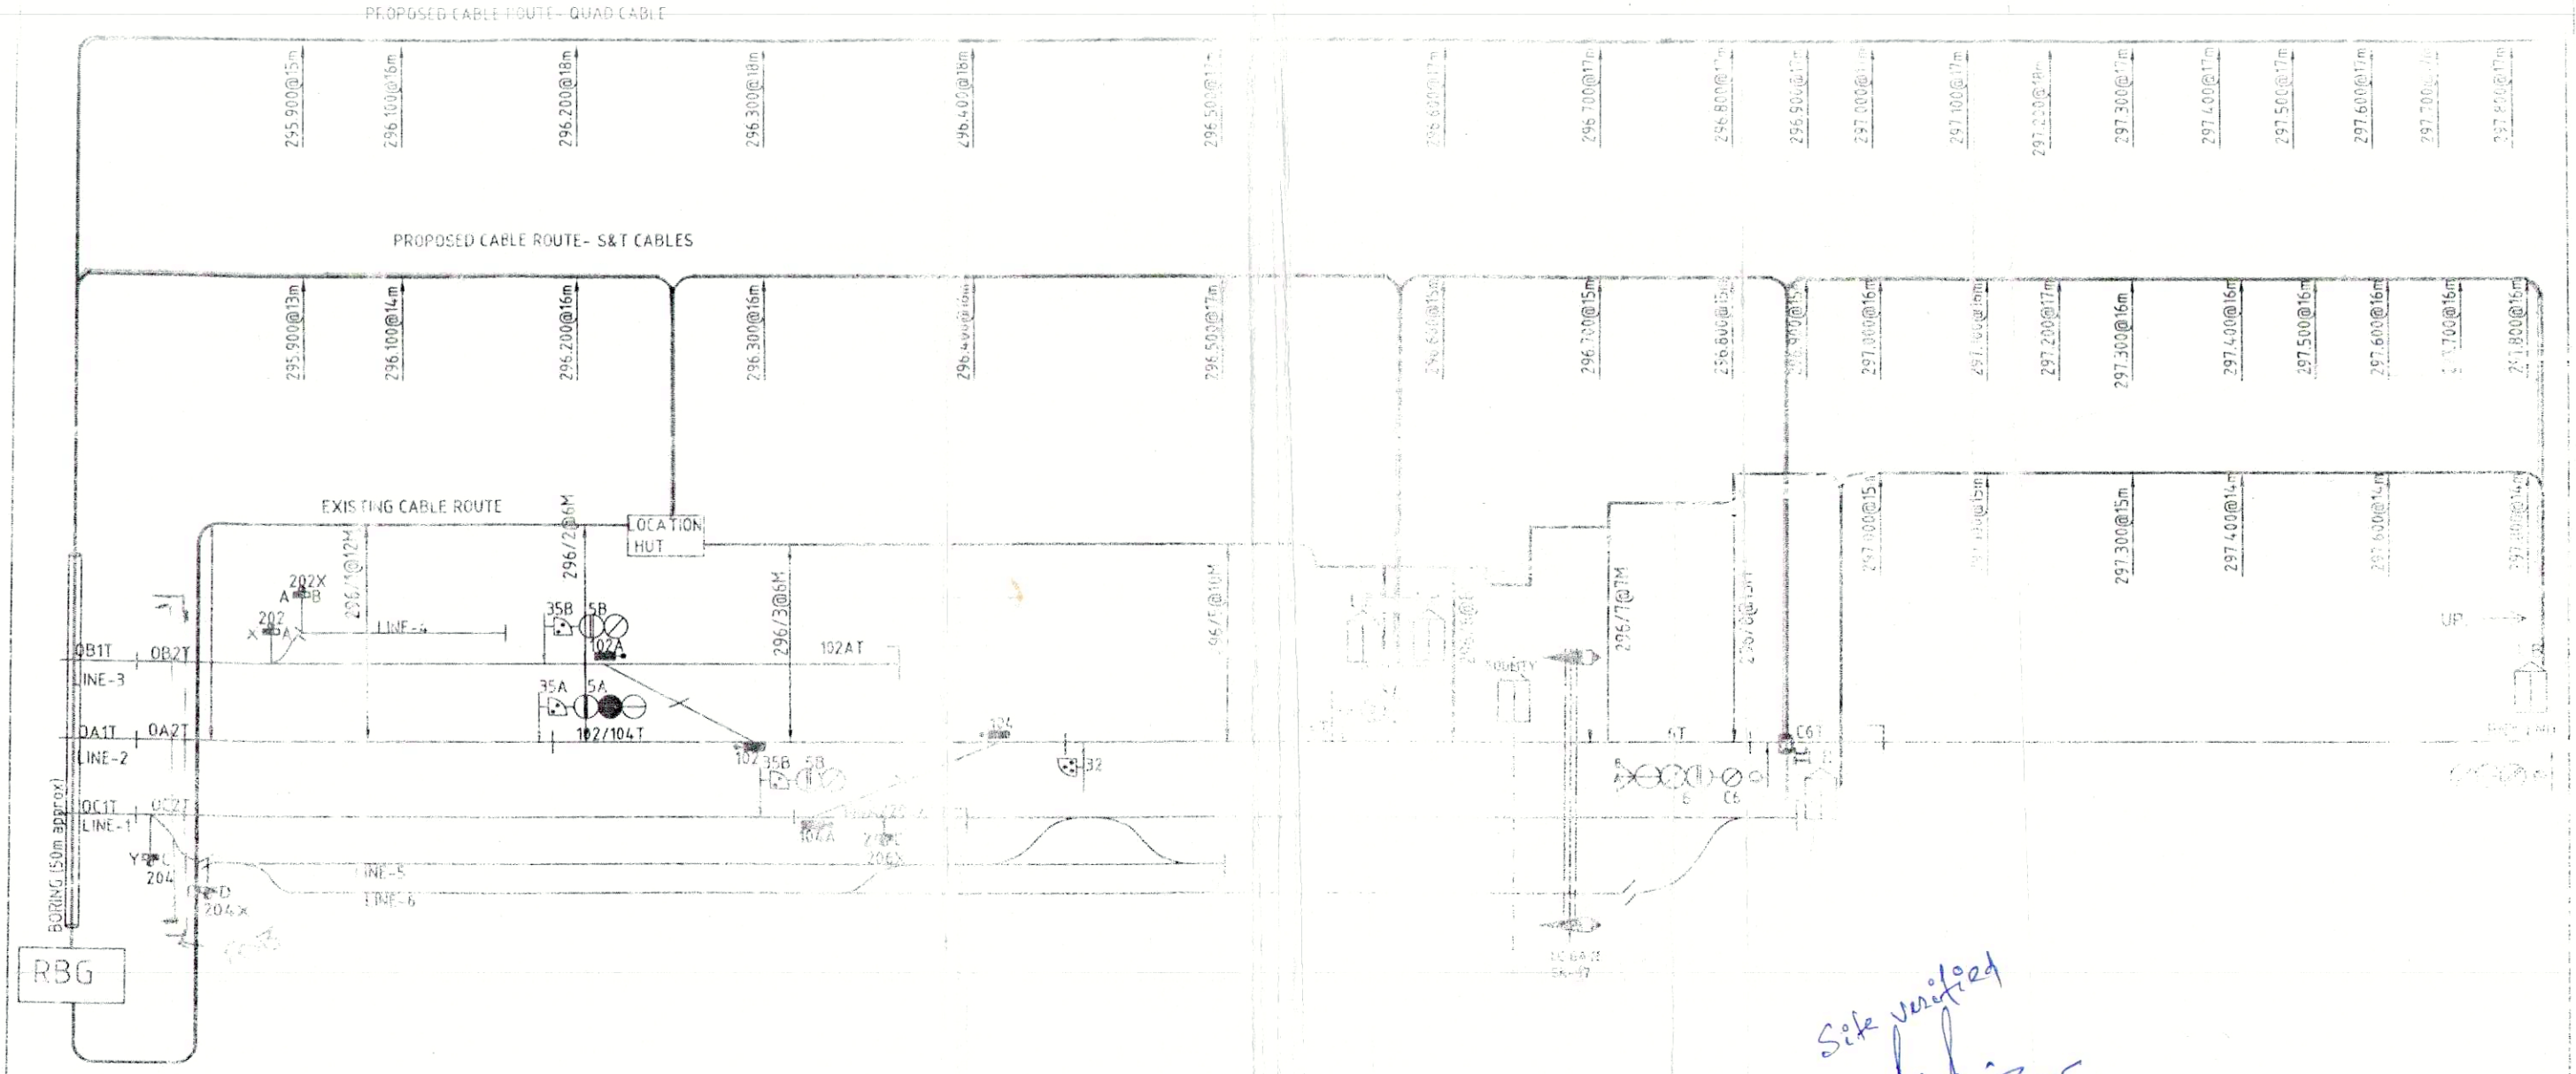

NOTE:- ALL MEASUREMENTS ARE FROM MAIN LINE
⇒ EXISTING SHOWN IN BLACK & PROPOSED SHOWN IN RED

Site verified
SSE/S/I/C/BNGN

SR.DSTE/RNY | SR.DSN-I/RNY | GGM/E2/RNY

designed by
KEC-ABEPL JV
GURUGRAM
SIGNATURE OF THE CONTRACTOR

पु.सी.रेलवे
N F R

(E/SE/SSE/SIG)	SSE(ELECT)	SSE/P.WAY(I.C)	SSE/WORKS				ADEN/BPRD				
(SPRD)	(BNGN)	(BPRD)	(BPRD)								

TO SUITE SSTE's SIP No XX

CABLE ROUTE PLAN (PROPOSED)
BARPETA ROAD(B.G)

SCALE:NOT TO SCALE

SHEET

NOTE:- 1) ALL MEASUREMENTS ARE FROM MAIN LINE.
2) EXISTING SHOWN IN BLACK & PROPOSED SHOWN IN RED

Site verified
SSE/SIG/BNAN
ASTO/BNAN

designed by.
KEC-ABEPL JV
GURUGRAM
SIGNATURE OF THE CONTRACTOR

पू.सी.रेलवे
N.F.R

JE/SE/SSE(SIG.) (GPRD)
SSE(ELEC) (GNOM)
SSE/WD (GNOM)
SSE/SIG/ELEC (GNOM)
SSE/SIG/ELEC (GNOM)
AEN/PRD
DRAWN

CABLE ROUTE PLAN (PROPOSED)
BARPETA ROAD(B G)
SCALE NOTED SCALE